
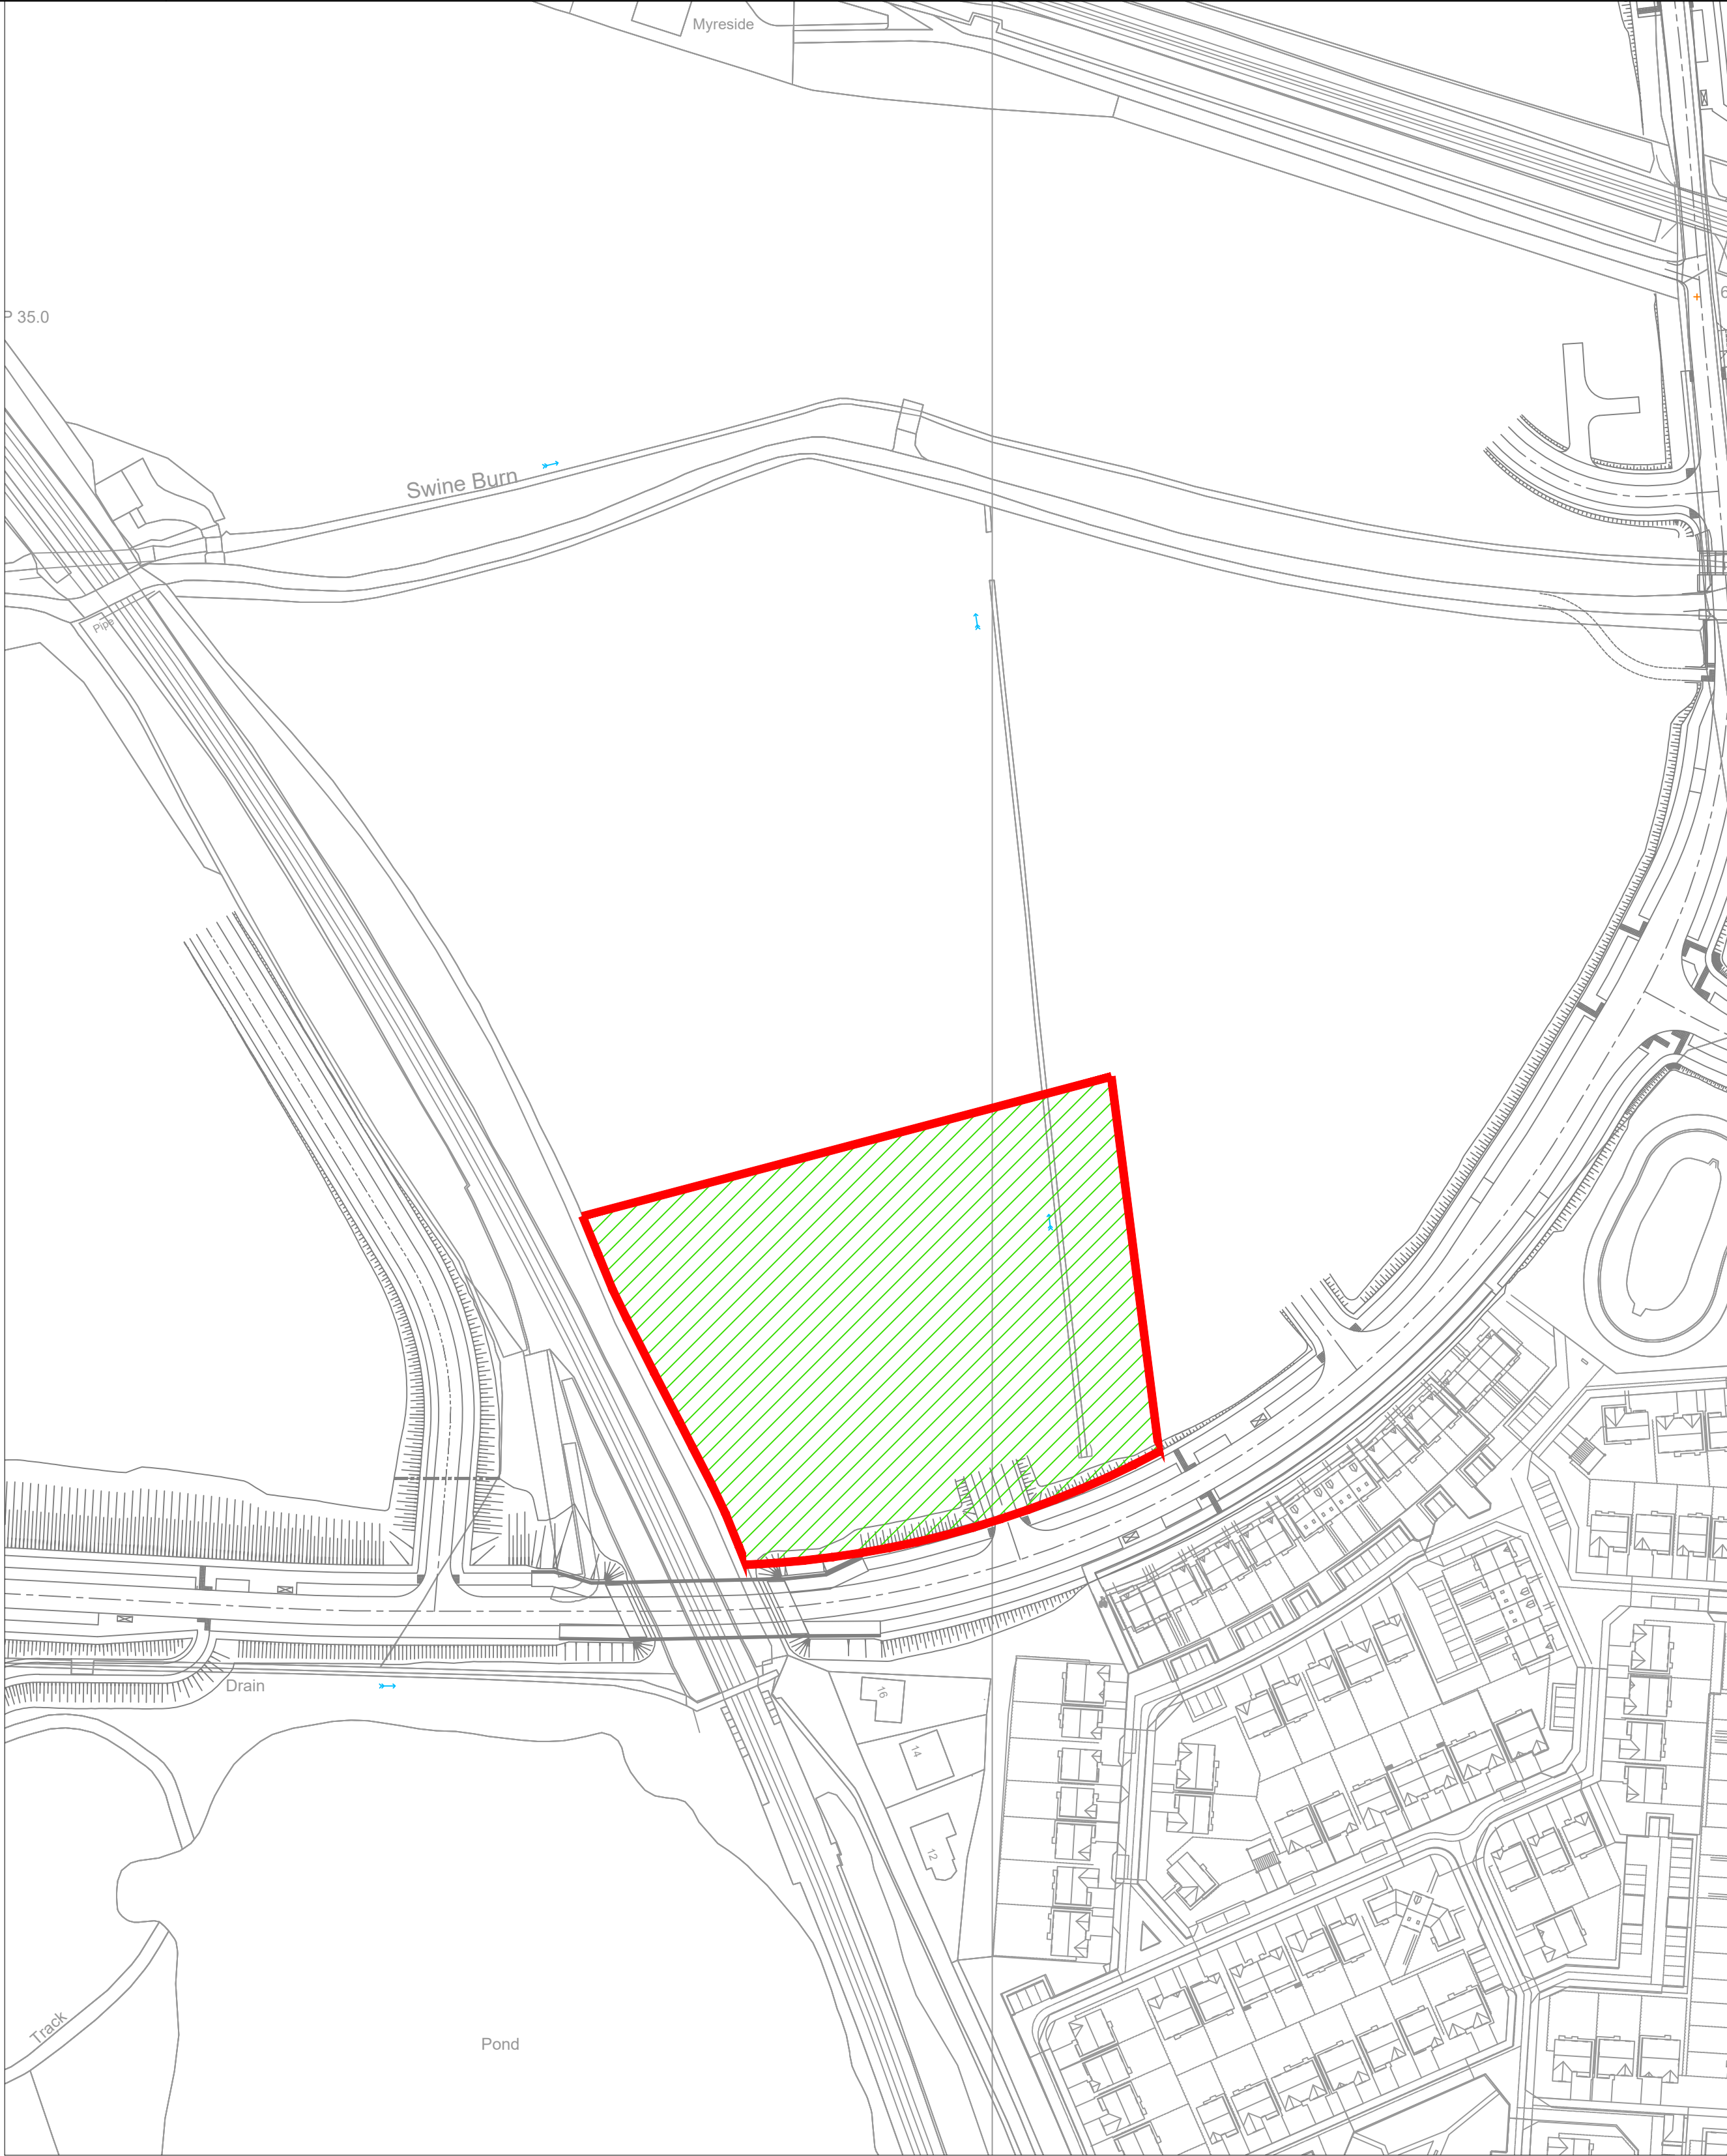



Block Z - Current Boundary  
Area: 1.25 Hectares (3.08 acres)  
Use:  Park and Ride



Block Z - Proposed Boundary  
Area: 1.22 Hectares (3.01 acres)  
Use:  Residential

NOTES

1. This drawing is to be read in conjunction with all other drawings and specifications.
2. Do not scale off this drawing. Written dimensions to be taken only.
3. Any discrepancies found between this drawing and other drawings and specifications in the construction documents must be referred to the Landscape Architect prior to work commencing.
4. This drawing must not be copied in whole or in part without prior written consent of Optimised Environments Ltd.

DRAWING INFORMATION BASED UPON


**Emapsite:** © Crown copyright and database rights 2019  
Ordnance Survey 0100031673.

**OS OpenData:** Contains OS data © Crown copyright and database right (2019).

**Google Earth:** Please show the attribution statement shown on the Google map or image that you are using.

**Topographical Survey:** Please reference surveyor's survey.

KEY PLAN

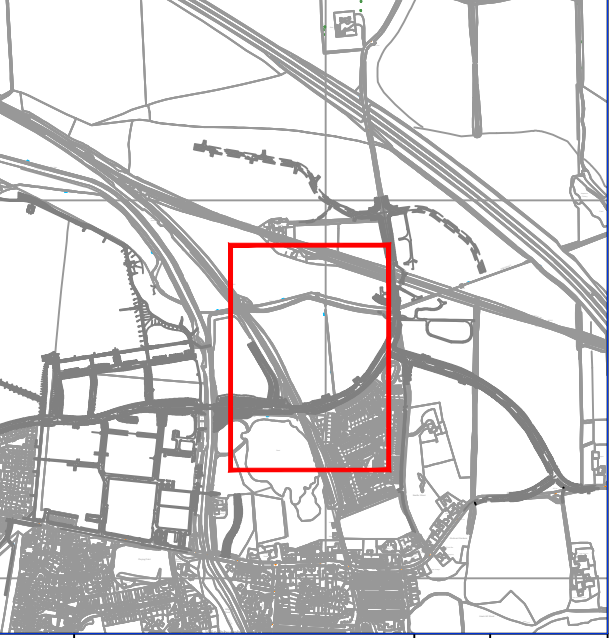

Issue	Revision	Initial	Date

**open**  
optimised environments

optimised environments ltd

EDINBURGH 2nd Floor | Quartermile Two | 2 Lister Square | Edinburgh | EH3 9GL  
t 0131 221 5520    [www.optimisedenvironments.com](http://www.optimisedenvironments.com)

LONDON Unit 6 | 36-42 New Inn Yard | Shoreditch | London | EC2A 3EY  
t 0203 984 4032    [www.optimisedenvironments.com](http://www.optimisedenvironments.com)

MANCHESTER 86 Phoenix Street | Manchester | M1 3NG  
t 0161 696 7550    [www.optimisedenvironments.com](http://www.optimisedenvironments.com)

© Optimised Environments Ltd 2022. Registered in Scotland. 0100094. Registered address: 2nd Floor, Quartermile Two, 2 Lister Square, Edinburgh, EH3 9GL.

Client

**Winchburgh Developments Ltd.**

Project

**Winchburgh**

**West Lothian**

Drawing Title

**Block Z**

**Development Boundary Proposed Amendment and Change of Use**

Scale Bar

12.5m 25m 37.5m 50m 62.5m

North

Scale: **1:1250@A1** Date: **January 2022**

By: **cs** Status: **PLANNING**

Checked: **il** Approved: **pmac**

Drawing Number

**100094\_WB\_Block-Z\_Planning**

Rev

-

Computer File: P:\2010\100094\_Winchburgh\_00\CAD\SHEET\00Plot\Block Z